

APPROVED JURISDICTIONAL DETERMINATION FORM
U.S. Army Corps of Engineers

This form should be completed by following the instructions provided in Section IV of the JD Form Instructional Guidebook.

SECTION I: BACKGROUND INFORMATION

A. REPORT COMPLETION DATE FOR APPROVED JURISDICTIONAL DETERMINATION (JD): November 24, 2015

B. ST PAUL, MN DISTRICT OFFICE, FILE NAME, AND NUMBER: New Glarus Wasche Center and Storage, 2014-01107-SEK (Stormwater pond)

C. PROJECT LOCATION AND BACKGROUND INFORMATION:

State: **Wisconsin** County/parish/borough: **Green** City: **New Glarus**
Center coordinates of site (lat/long in degree decimal format): Lat. **42.80363° N**, Long. **-89.63123° W**.

Universal Transverse Mercator: **16**

Name of nearest waterbody: **Little Sugar River, Ledger School Branch**

Name of watershed or Hydrologic Unit Code (HUC): **Upper Mississippi Region (07090004)**

- Check if map/diagram of review area and/or potential jurisdictional areas is/are available upon request.
 Check if other sites (e.g., offsite mitigation sites, disposal sites, etc...) are associated with this action and are recorded on a different JD form.

D. REVIEW PERFORMED FOR SITE EVALUATION (CHECK ALL THAT APPLY):

- Office (Desk) Determination. Date: **October 23, 2015**
 Field Determination. Date(s):

SECTION II: SUMMARY OF FINDINGS

A. RHA SECTION 10 DETERMINATION OF JURISDICTION.

There are no "navigable waters of the U.S." within Rivers and Harbors Act (RHA) jurisdiction (as defined by 33 CFR part 329) in the review area.

B. CWA SECTION 404 DETERMINATION OF JURISDICTION.

There are no "waters of the U.S." within Clean Water Act (CWA) jurisdiction (as defined by 33 CFR part 328) in the review area.

SECTION III: CWA ANALYSIS

A. TNWs AND WETLANDS ADJACENT TO TNWs: N/A

B. CHARACTERISTICS OF TRIBUTARY (THAT IS NOT A TNW) AND ITS ADJACENT WETLANDS (IF ANY): N/A

C. SIGNIFICANT NEXUS DETERMINATION: N/A

D. DETERMINATIONS OF JURISDICTIONAL FINDINGS. THE SUBJECT WATERS/WETLANDS ARE (CHECK ALL THAT APPLY): N/A

E. ISOLATED [INTERSTATE OR INTRA-STATE] WATERS, INCLUDING ISOLATED WETLANDS, THE USE, DEGRADATION OR DESTRUCTION OF WHICH COULD AFFECT INTERSTATE COMMERCE, INCLUDING ANY SUCH WATERS (CHECK ALL THAT APPLY): N/A

F. NON-JURISDICTIONAL WATERS, INCLUDING WETLANDS (CHECK ALL THAT APPLY):

- If potential wetlands were assessed within the review area, these areas did not meet the criteria in the 1987 Corps of Engineers
 Other: (explain, if not covered above): **The stormwater pond is approximately 0.07-acre in size and was constructed to meet the requirements of Section 402 CWA.**


SECTION IV: DATA SOURCES.

A. SUPPORTING DATA. Data reviewed for JD (check all that apply - checked items shall be included in case file and, where checked and requested, appropriately reference sources below):

- Maps, plans, plots or plat submitted by or on behalf of the applicant/consultant: **Montgomery Associates Proposed Site Plan 9-22-15; NRC Wetland Delineation 7-15-2002**
 Data sheets prepared/submitted by or on behalf of the applicant/consultant.
 Office concurs with data sheets/delineation report.
 Office does not concur with data sheets/delineation report.
 Data sheets prepared by the Corps:
 Corps navigable waters' study:
 U.S. Geological Survey Hydrologic Atlas:

- USGS NHD data.
- USGS 8 and 12 digit HUC maps.
- U.S. Geological Survey map(s). Cite scale & quad name: 1:24K Quad WI-New Glarus
- USDA Natural Resources Conservation Service Soil Survey. Citation: Green County
- National wetlands inventory map(s). Cite name:
- State/Local wetland inventory map(s): Wisconsin Wetland Inventory
- FEMA/FIRM maps:
- 100-year Floodplain Elevation is: (National Geodetic Vertical Datum of 1929)
- Photographs: Aerial (Name & Date):
or Other (Name & Date):
- Previous determination(s). File no. and date of response letter:
- Applicable/supporting case law:
- Applicable/supporting scientific literature:
- Other information (please specify):


B. ADDITIONAL COMMENTS TO SUPPORT JD: The review area contains one aquatic resource that was constructed to meet the requirements of Section 402 of the Clean Water Act. Under 33 CFR 328(a)(8), waste treatment systems including treatment ponds designed to meet the requirements of CWA are not waters of the U.S. Therefore, this aquatic resource is not jurisdictional under Section 404 of the CWA.

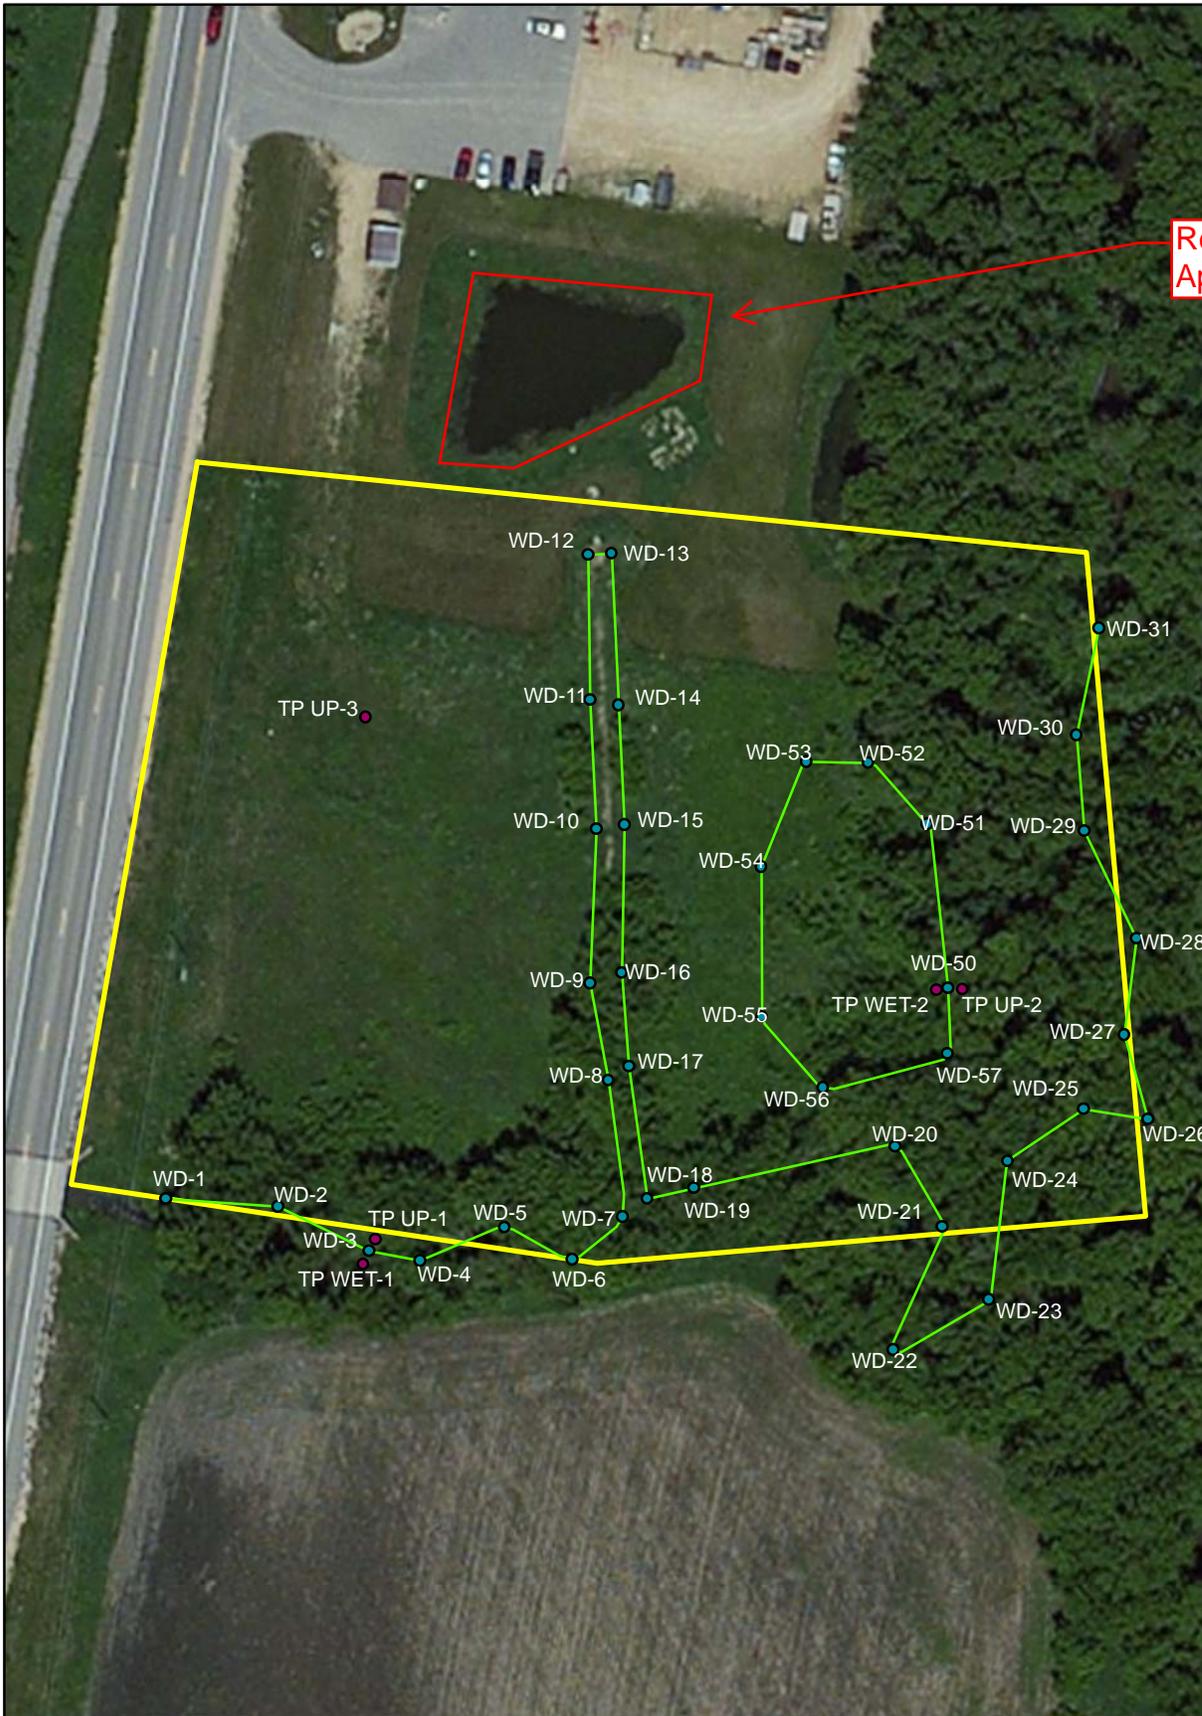

Review area for Approved JD

Legend

- Test Pits
- Delineation Points
- Wetland Delineation
- ▭ Property Boundary

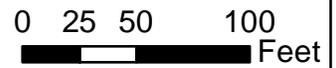

1 inch = 84 feet

Drawn By:
Daniel Fuhs

Date:
11/19/2013

Project Number:
13087

Figure 3 of 3



ECO-RESOURCE CONSULTING, LLC

409 Concord Drive Oregon, WI 53575
www.eco-resource.net

Fig 3. Wetland Delineation
Neff Enterprises, LLC
Section 23, T4N, R7E
New Glarus, WI

